
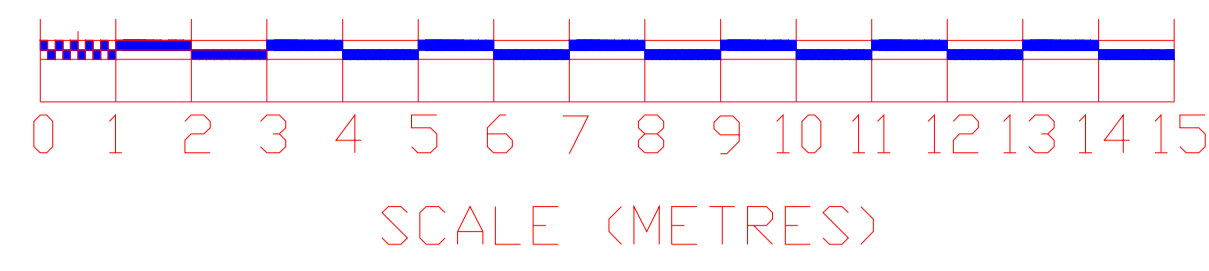


TREE SCHEDULE			
REFERENCE	TRUNK DIAMETER	SPREAD	HEIGHT
TREE1	0.200	3.000	3.500
TREE2	0.800	10.000	14.000
TREE3	0.250	4.000	13.000
TREE4	0.400	7.000	14.000
TREE5	0.400	4.000	9.000
TREE6	0.200	5.000	3.000

CONTROL STATIONS				
REFERENCE	POINT STYLE	EASTING	NORTHING	HEIGHT
▲ STN1	HILT I NAIL	982.064	2014.759	68.098
▲ STN2	HILT I NAIL	961.311	2024.261	66.319

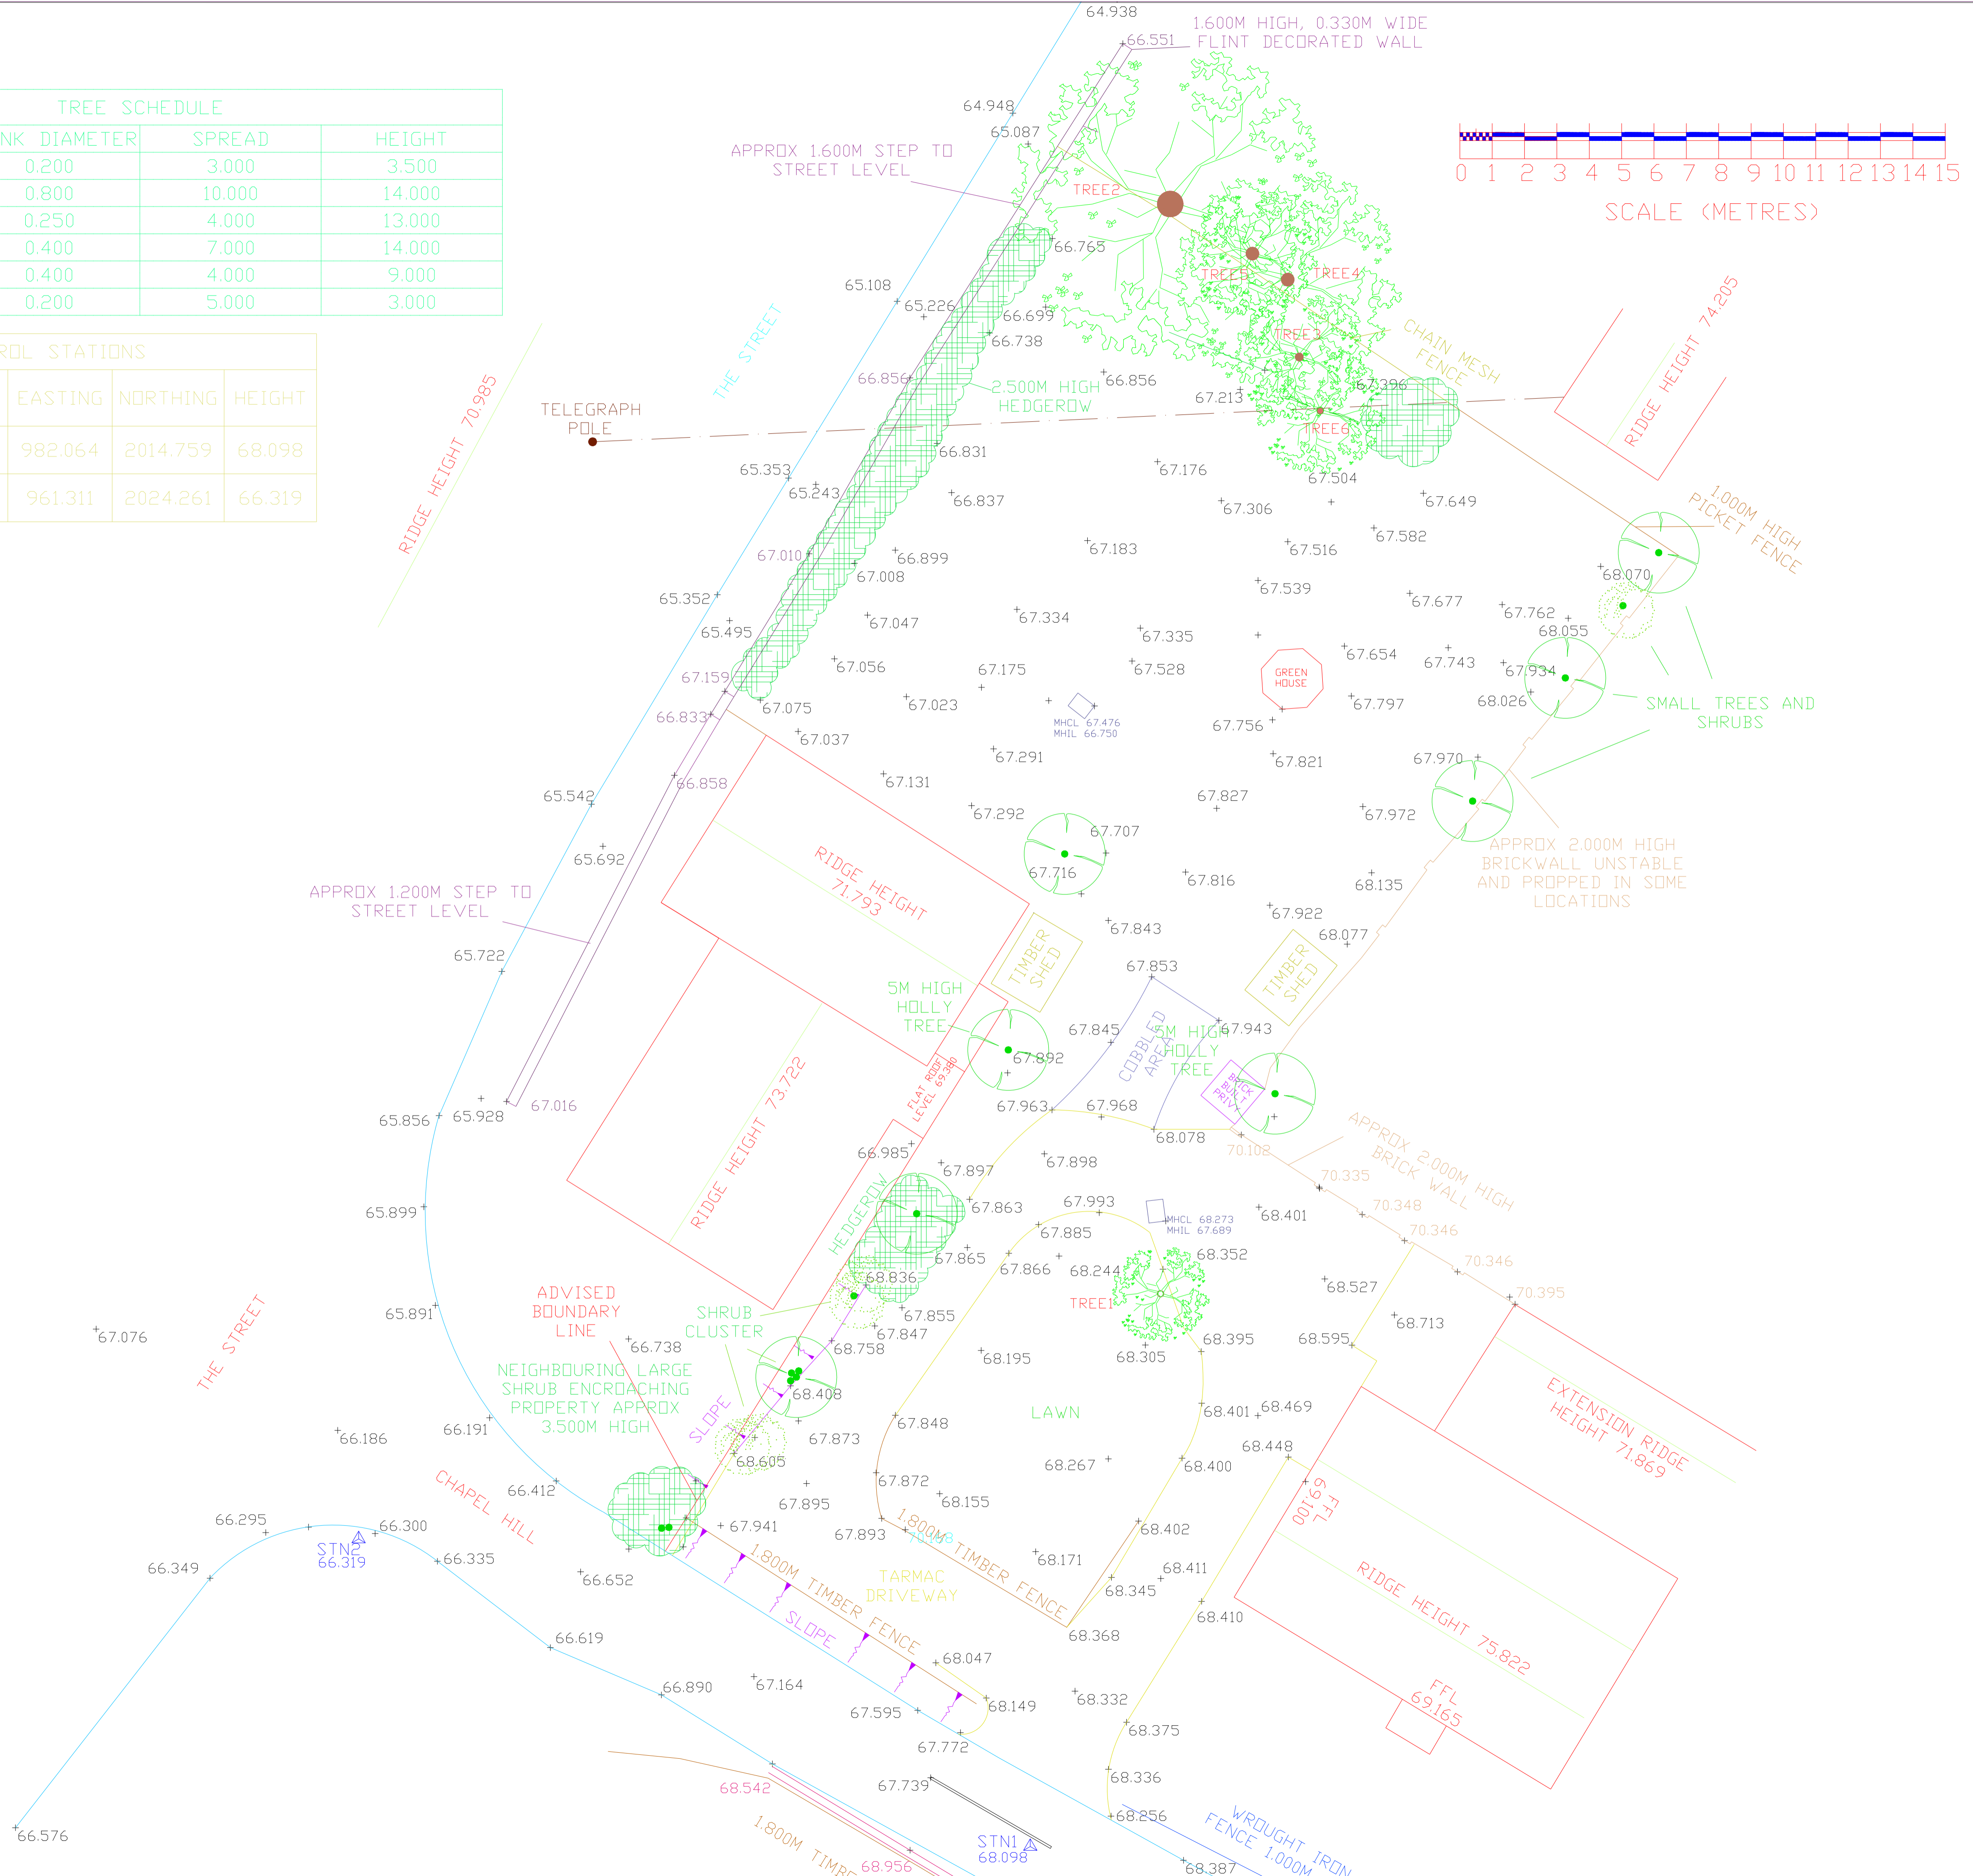

© This drawing remains the property of Pinpoint Engineer Ltd and shall not be copied without prior written consent.

All dimensions to be checked on site and any discrepancies to be reported before work commences.

Tree information including species, heights, diameters, position and spread are an approximation only and is subject to discrepancy, should accurate and detailed information be required a specialist should be sought.

If scaling off this drawing the scale bar should be utilised to verify paper size is correct.

Inaccessible survey points and lines due to lack of visibility or obstacles have been replaced with predicted/projected lines. Surrounding property eaves, ridge and building locations have multiple projected lines.

Building outlines are shown in red, roof outlines are shown in green - when printing in black and white - generally the inner lines are the building lines.

An arbitrary level datum has been utilised for this survey and therefore does not relate to the ordnance survey grid nor the ordnance datum.

A	Additional survey points and details included as per client request.	RDM	11/01/17
Rev	Comment	By	Date

TEL: 0781 5958772  
 E-MAIL: RDM@PINPOINTENGINEER.CO.UK  
 WEST: PINPOINTENGINEER.CO.UK  
 ADDRESS: 37, CHESTERTON DRIVE,  
 MERSTHAM, SURREY, RH1 3NZ

Client:		
MRS J MOTT		
Job Title:		
LAND ADJACENT WHITE COTTAGE CHapel Hill EFFINGHAM SURREY		
Drawing Title:		
TOPOGRAPHICAL SURVEY		
Status:		
INFORMATION		
Date Drawn:	Drawn By:	Scale:
08/01/2017	RDM	A1 1:100
Job Reference:	Dwg No:	Rev:
BH_TS001	BH001	A